1900 Gallon Vertical Tank

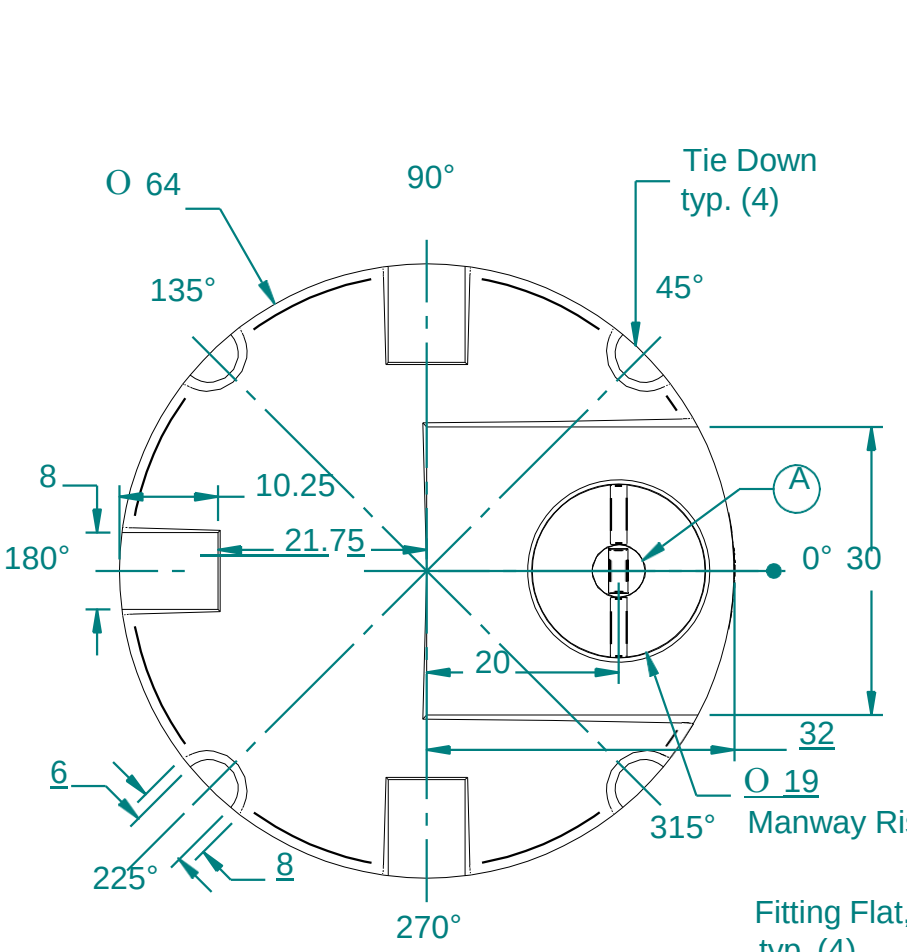

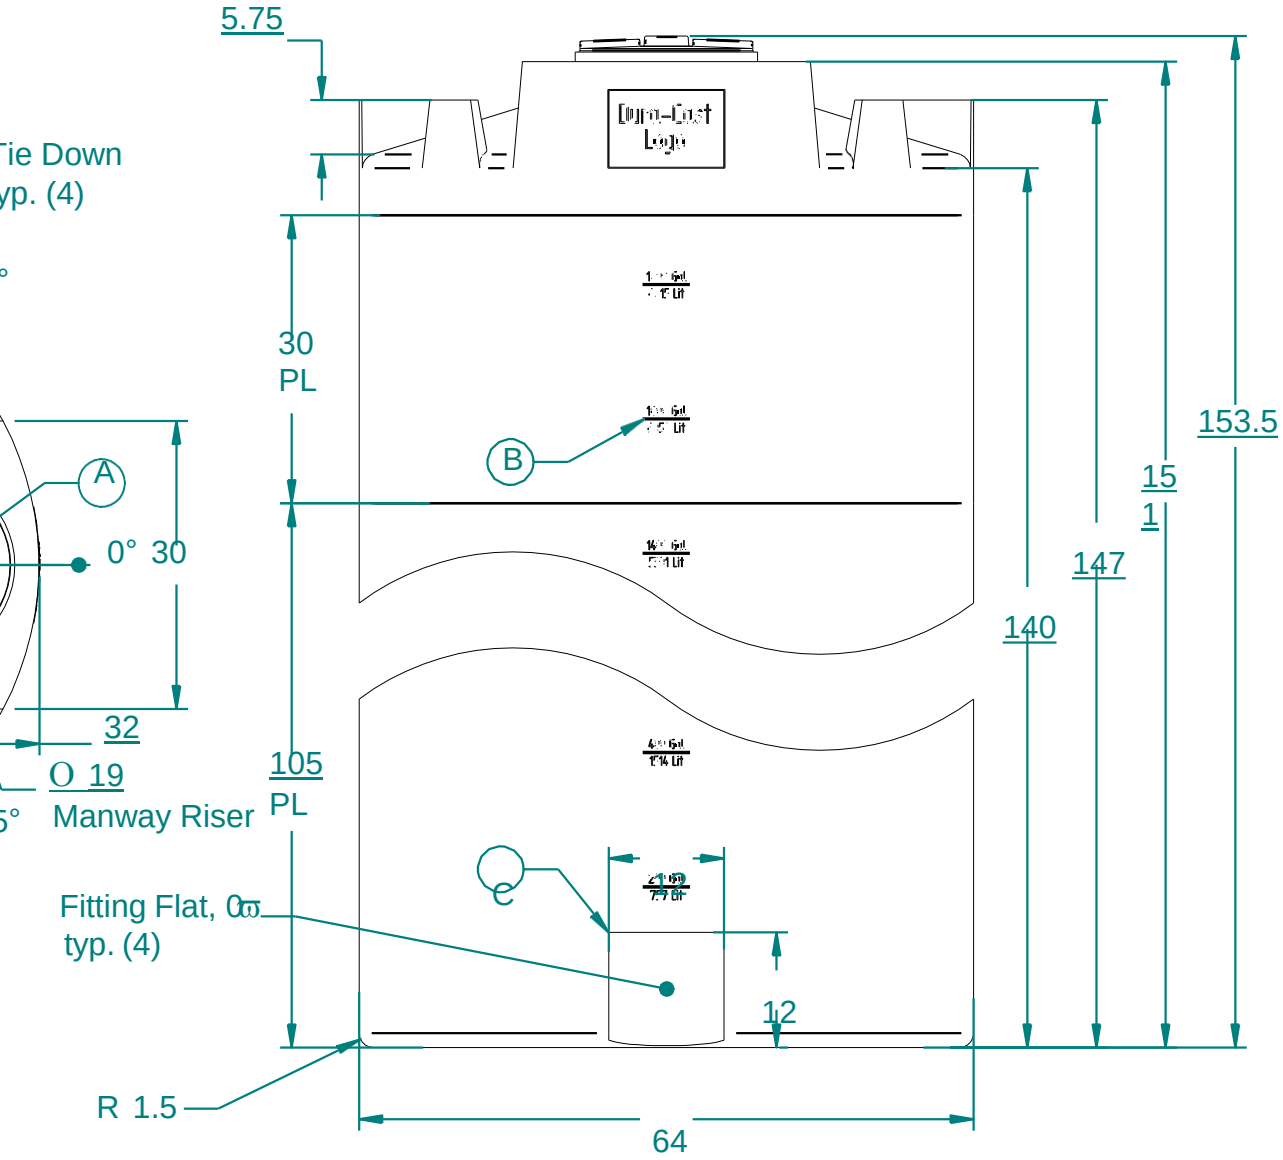

A. 18" HDPE Threaded -Vented Manway W/ 16" Access, Black, W/ SS Screws (P/N 751016)

B. Tank Calibration At 0° in 200 Gallon And 757 Liter Increments

C. Tank fittings to be installed at time of shipment as per Dura-Cast procedures

D. Underlined dimensions reflect as-built measurements from actual molded tank. Dimensions may vary by +/- 1%.

Weight: Dependent on specific gravity rating		NAME	DATE
Wall Thickness: Dependent on specific gravity rating	Drawn By:	SArant	5/29/2013
Customer Part No: N/A	Customer APPR		
Print Date: 5/29/2013	Copyright@2013 Dura-Cast Products, Inc.		
Comments: - UNLESS OTHERWISE SPECIFIED DIMENSIONS ARE IN INCHES - Std Radii 3/16"	UNLESS OTHERWISE SPECIFIED TOLERANCES ARE DIMS > 10" ±1% DIMS < 10" ±0.100 WALL THICKNESS ± 20% FLATNESS ±.030 in/in		

DURA-CAST
16160 Hwy 27 Lake Wales, FL 33859

Customer: Dura-Cast Products, Inc.

Part Title: 1900 Gallon Vertical Tank

File Name: 901900 1900 Gallon Vertical Tank As-Built 2013 05 29.dft

Size: A | Material: HDPE 942 | Rev.

Part No: 901900 | Do Not Scale | Sheet: 1 OF 1